
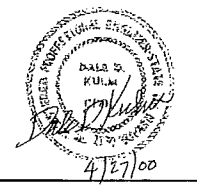
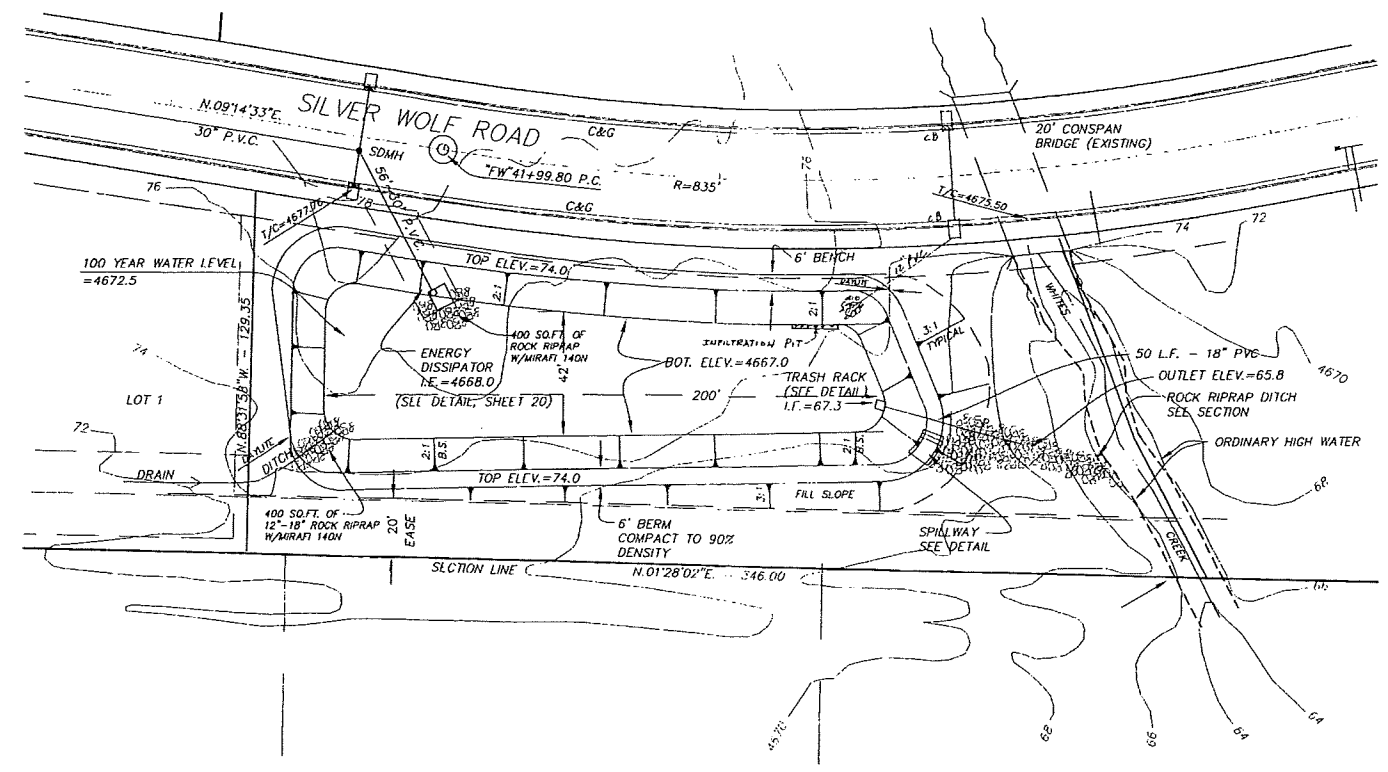
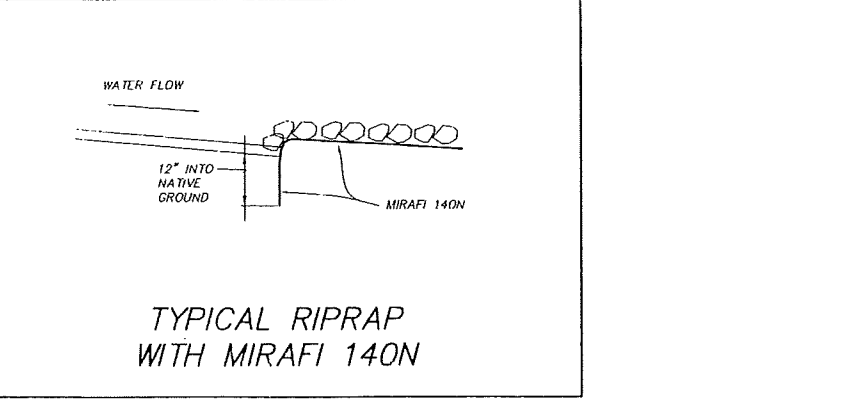
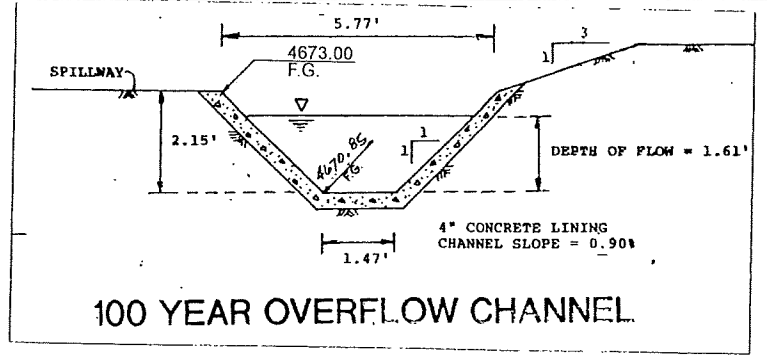
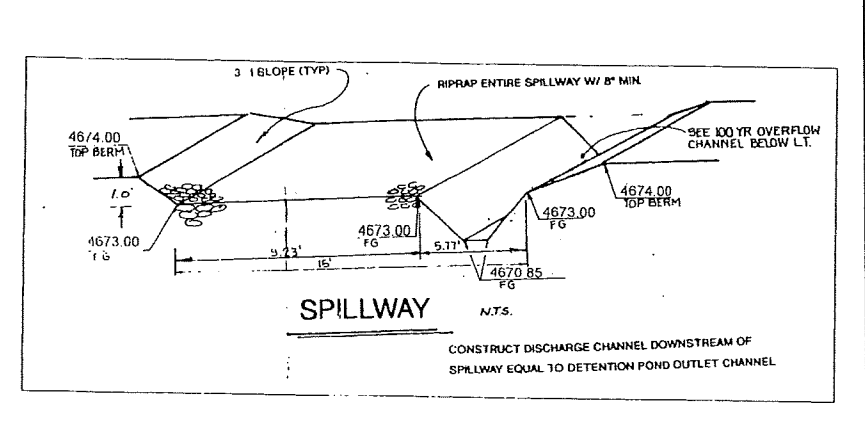


NO.	REVISION	DATE	STANDARD DETAILS FOR PUBLIC WORKS CONSTRUCTION	SECTION
				1

TRASH RACK
(24" PIPE AND SMALLER)

DATE	7-01	2002
DATE	14-11	2004
DATE	14-11	2004

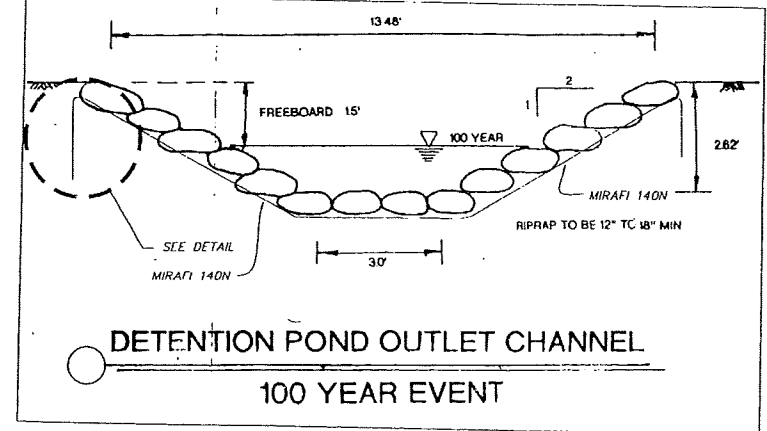

DETENTION POND	
UNIT NO. 12A	
A PORTION OF THE EAST 1/2 OF SECTION 19, T.18 N., R.20 E., M.D.M.	
COUNTY OF WASHOE	STATE OF NEVADA
DALE D. KULM & ASSOCIATES	SCALE 1"=30'
140 SELLS STREET	APRIL 2000
SPARKS, NV 89431	SHEET 18 OF 25

AS BUILT