


GRADING.DWG PRINTED 4-28-00

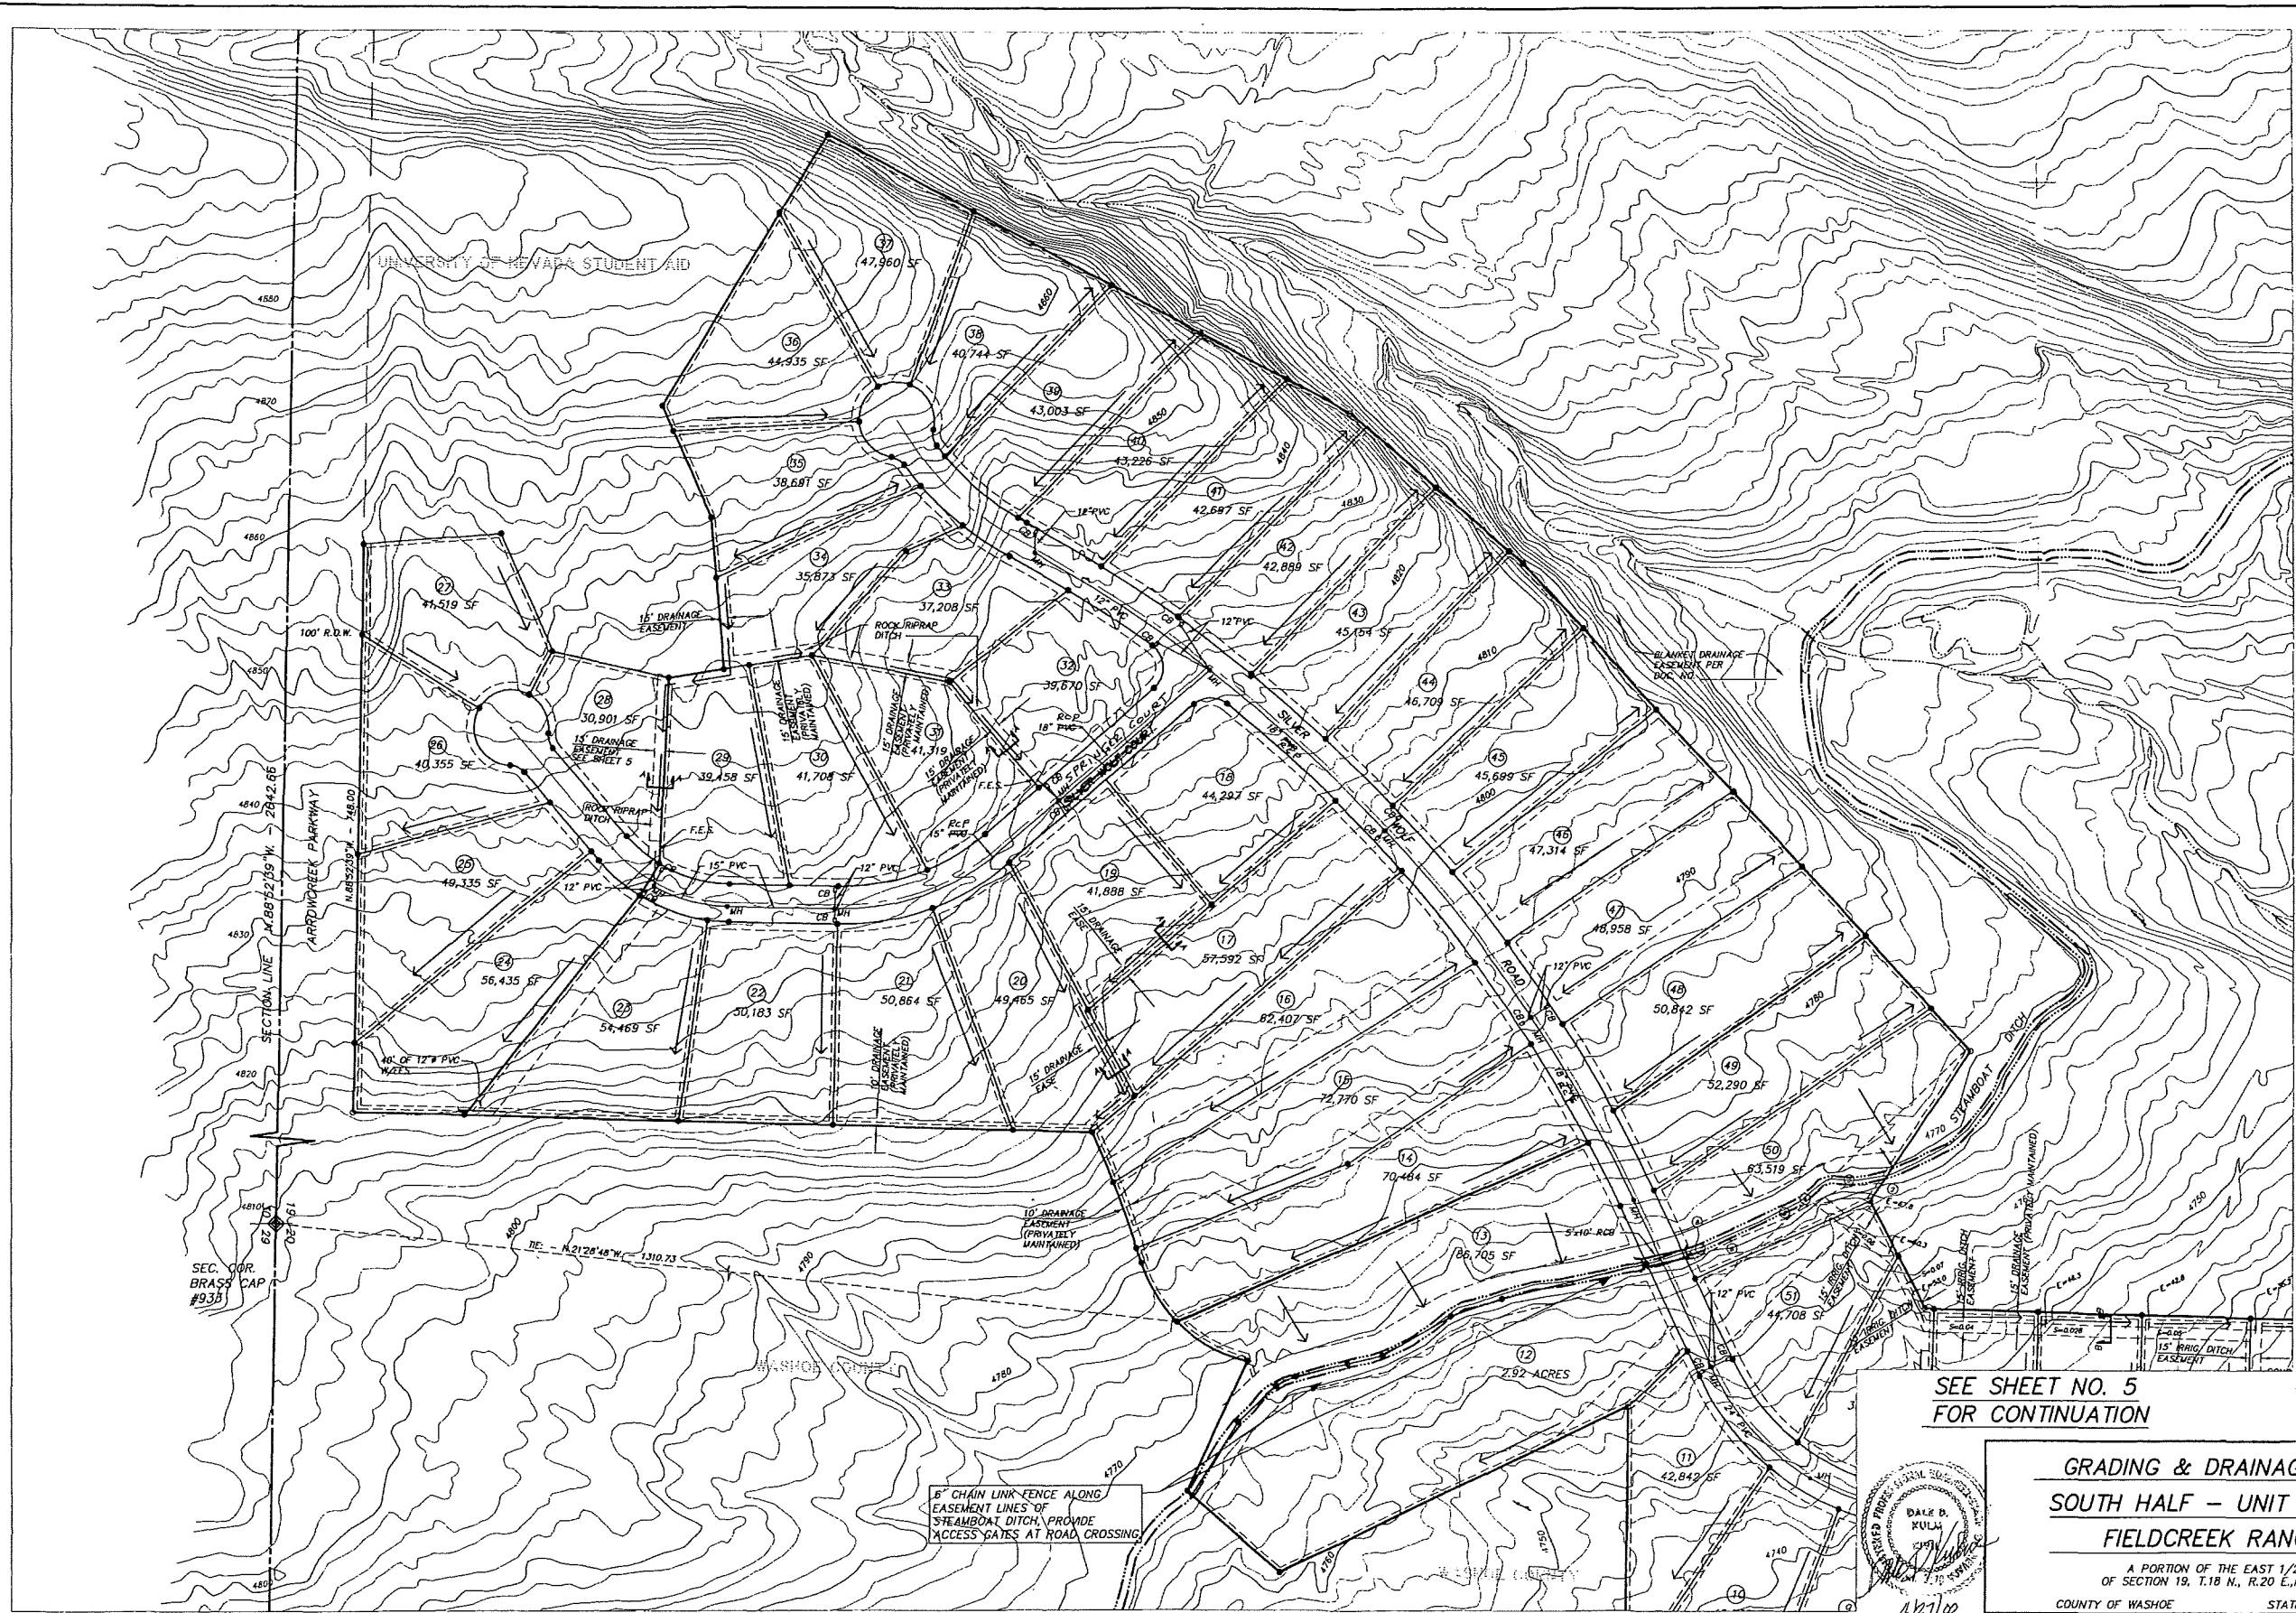

SEE SHEET NO. 5
FOR CONTINUATION

NORTH
SCALE 1"=100'


6" CHAIN LINK FENCE ALONG
EASEMENT LINES OF
STEAMBOAT DITCH, PROVIDE
ACCESS GATES AT ROAD CROSSING




GRADING & DRAINAGE PLAN
SOUTH HALF - UNIT NO. 12
FIELDCREEK RANCH

A PORTION OF THE EAST 1/2
 OF SECTION 19, T.18 N., R.20 E., M.D.M.
 COUNTY OF WASHOE STATE OF NEVADA
 DALE D. KULUM & ASSOCIATES SCALE 1"=100'
 140 SELLS STREET APRIL 2000
 SPARKS, NV 89431 SHEET 4 OF 25

AS BUILT.

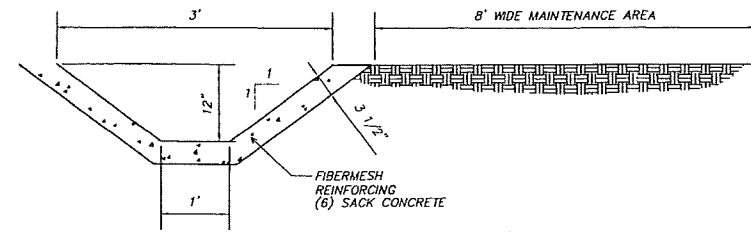


B-B CONCRETE LINED IRRIGATION DITCH
TYPICAL SECTION
NO SCALE

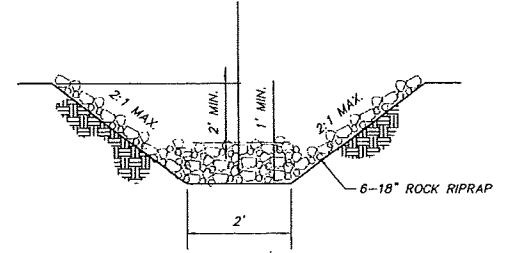


A-A TYPICAL SECTION
NO SCALE
ROCK LINED DRAINAGE CHANNEL

SEE SHEET NO. 4
FOR CONTINUATION

6' CHAIN LINK FENCE ALONG
EASEMENTS LINES OF
STEAMBOAT DITCH, PROVIDE
ACCESS GATES AT ROAD CROSSING

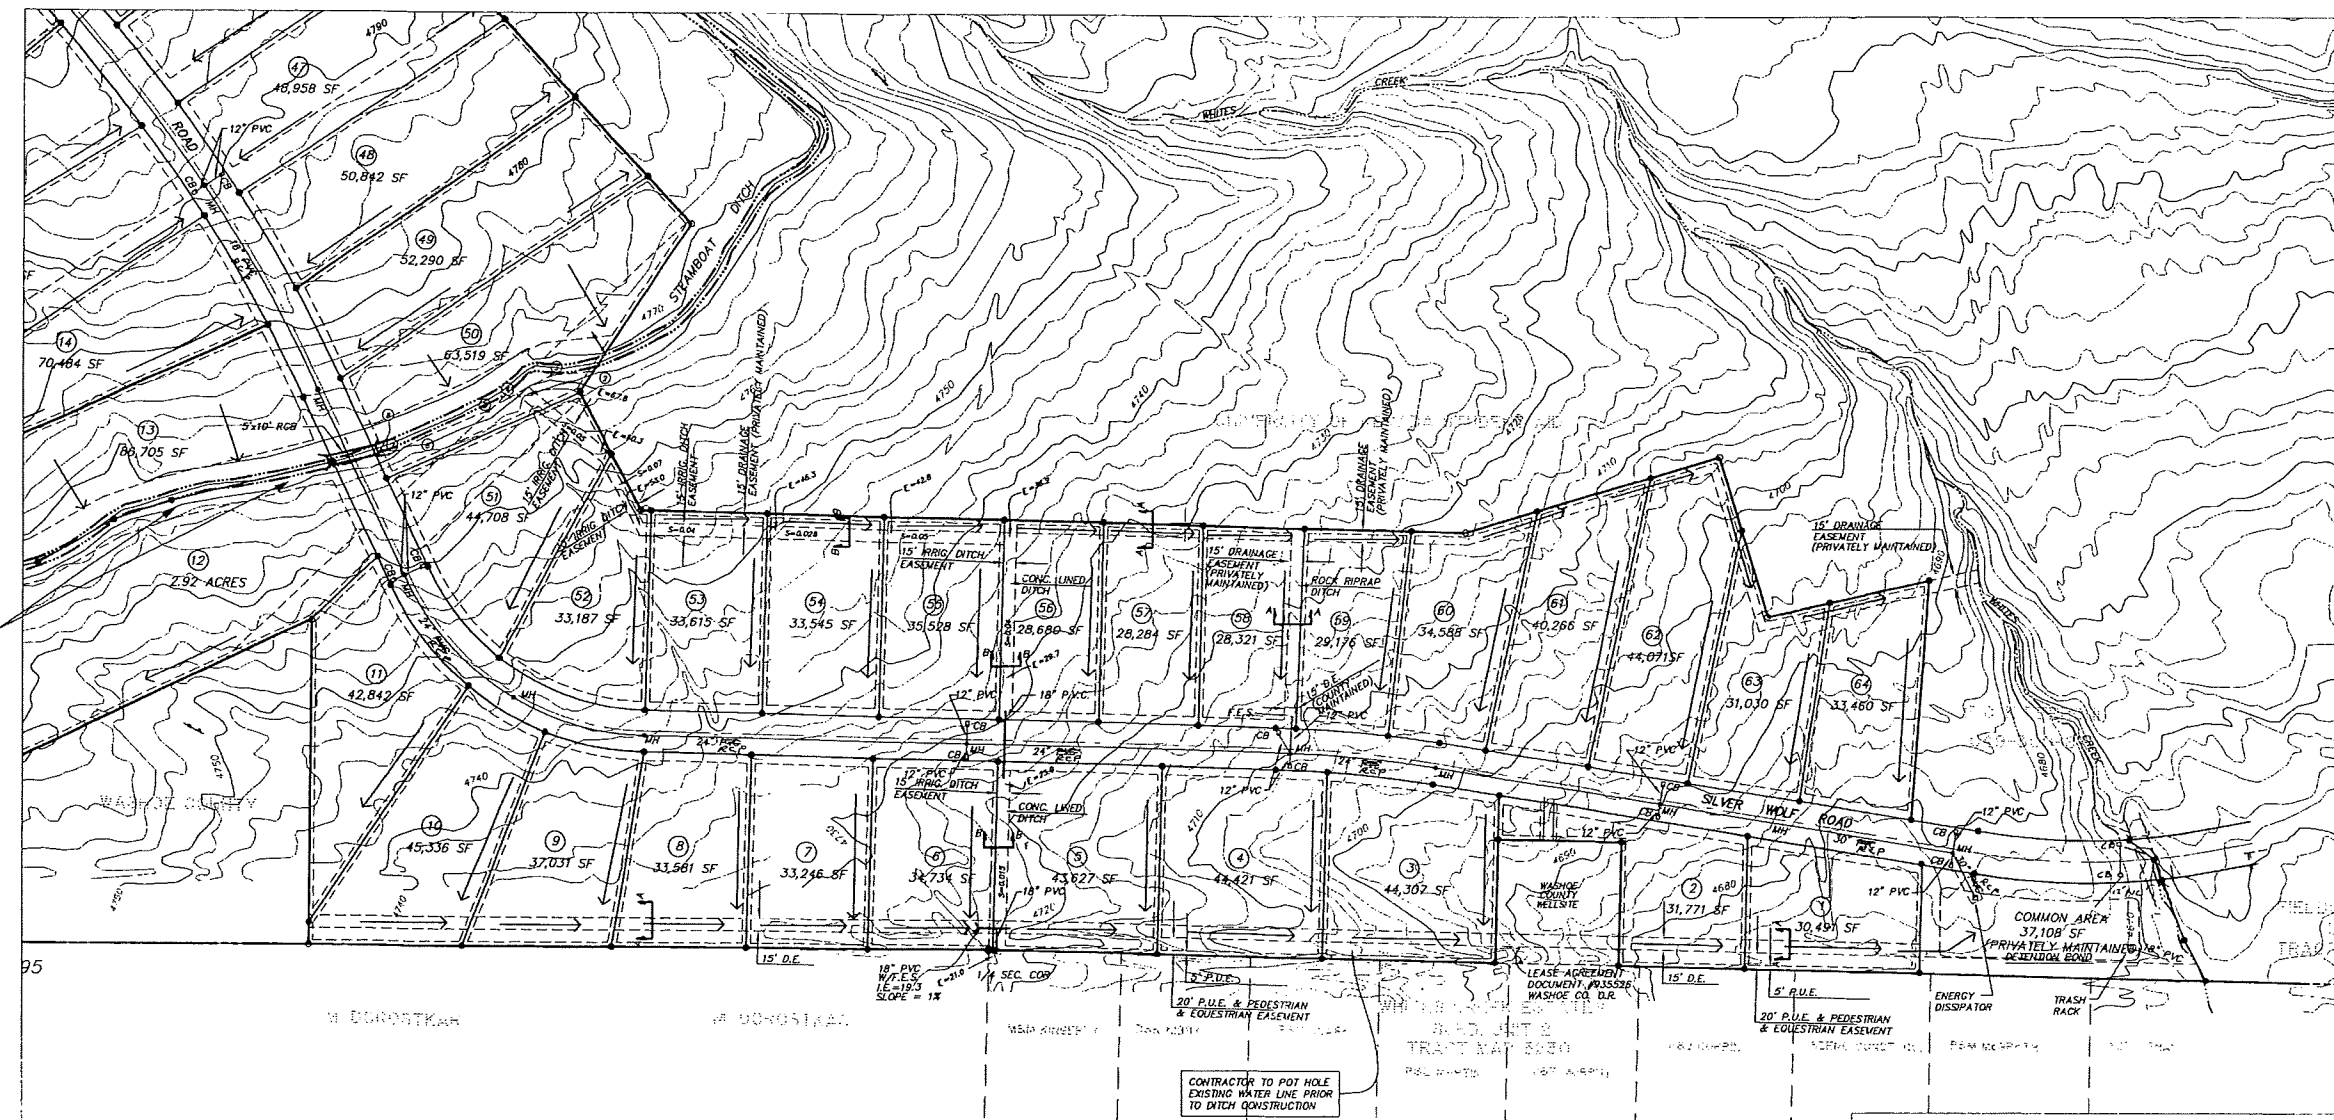

CONTRACTOR TO POT HOLE
EXISTING WATER LINE PRIOR
TO DITCH CONSTRUCTION

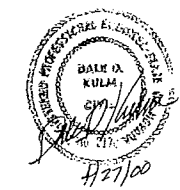

GRADING & DRAINAGE PLAN
NORTH HALF - UNIT NO. 12
FIELDCREK RANCH

A PORTION OF THE EAST 1/2
OF SECTION 19, T.18 N., R.20 E., M.D.M.

COUNTY OF WASHOE STATE OF NEVADA

DALE D. KULM & ASSOCIATES
140 SELLS STREET
SPARKS, NV 89431

SCALE 1"=100'
APRIL 2000
SHEET 5 OF 25

AS BUILT.